



REVISION HISTORY			
REV	DESCRIPTION	DATE	APPROVED
01	AS BUILT	05.07.07	O.J.DALE

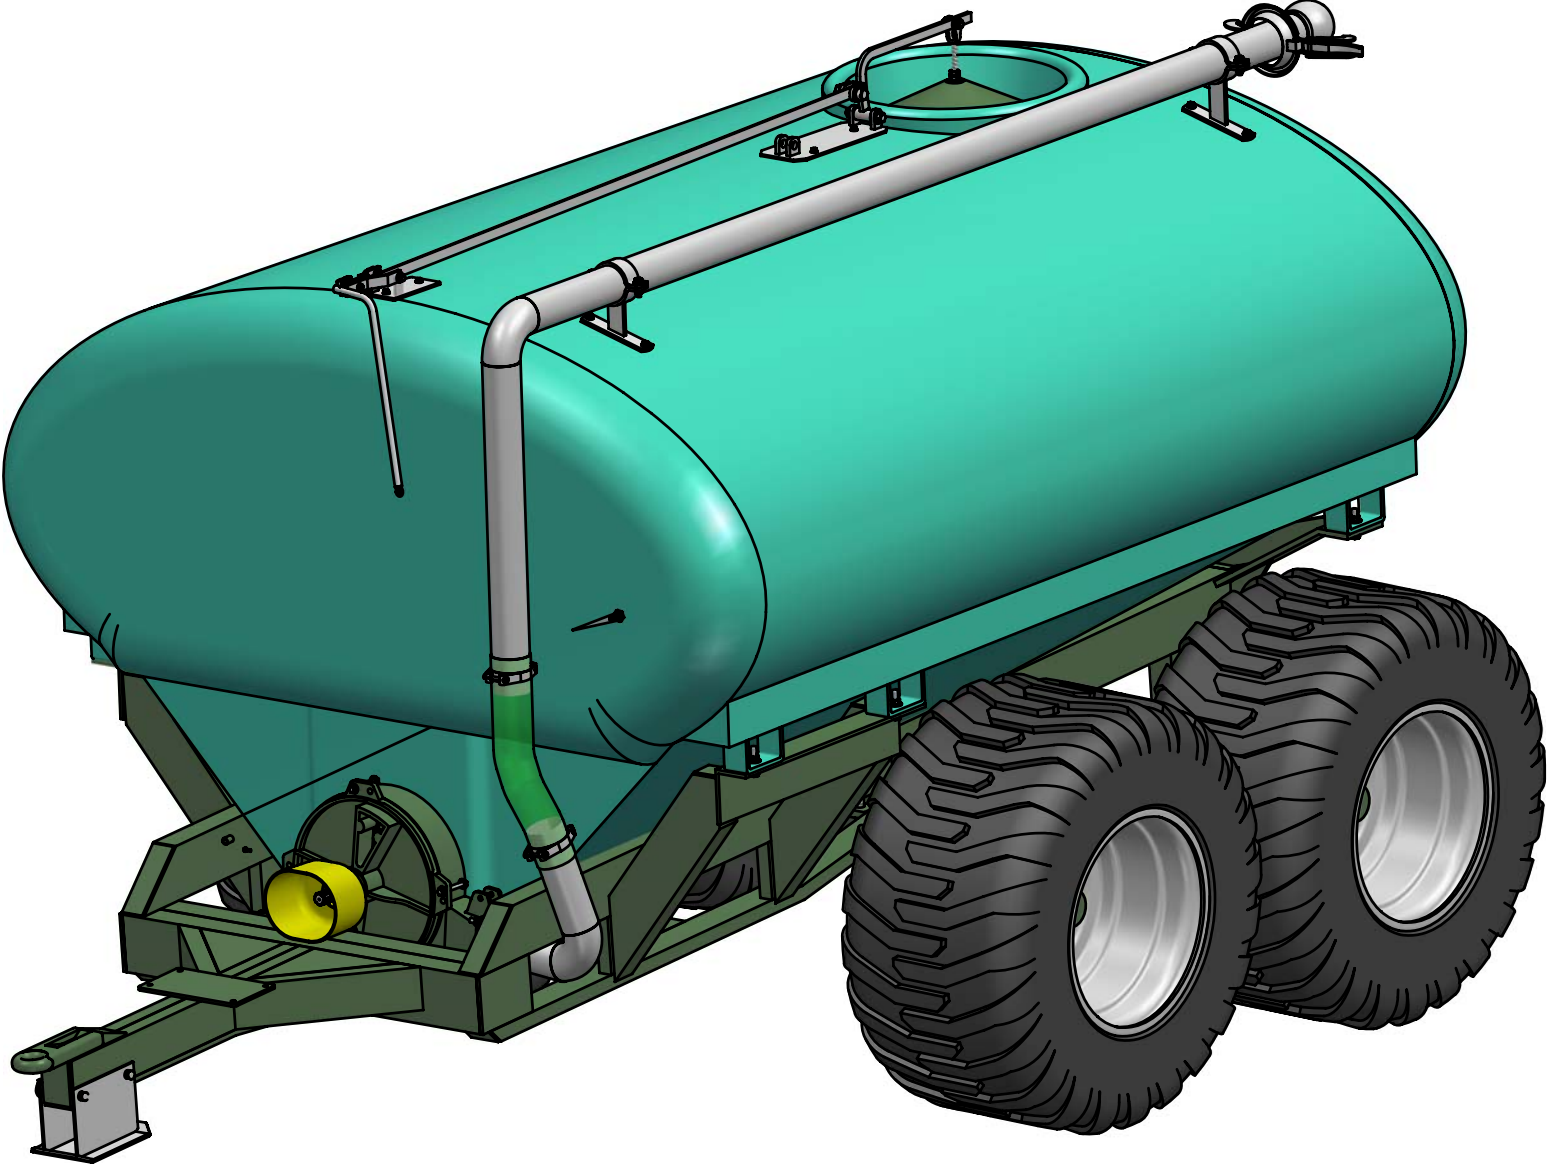

DRAWN		NAME	DATE	TITLE		
S. Hetland			05/07/07	FRONTPAGE DOFF XXX - STANDARD		
SIZE	DWG NO	REF TO	REV			
A3	C - 900		01			
FILE NAME: C - 900 - Doff X9 - Sammenstilling.dff						
SCALE: 1 : 14		WEIGHT:		SHEET 1 OF 1		

moi AS

REVISION HISTORY			
REV	DESCRIPTION	DATE	APPROVED
01	AS BUILT	05.07.07	O.J.DALE

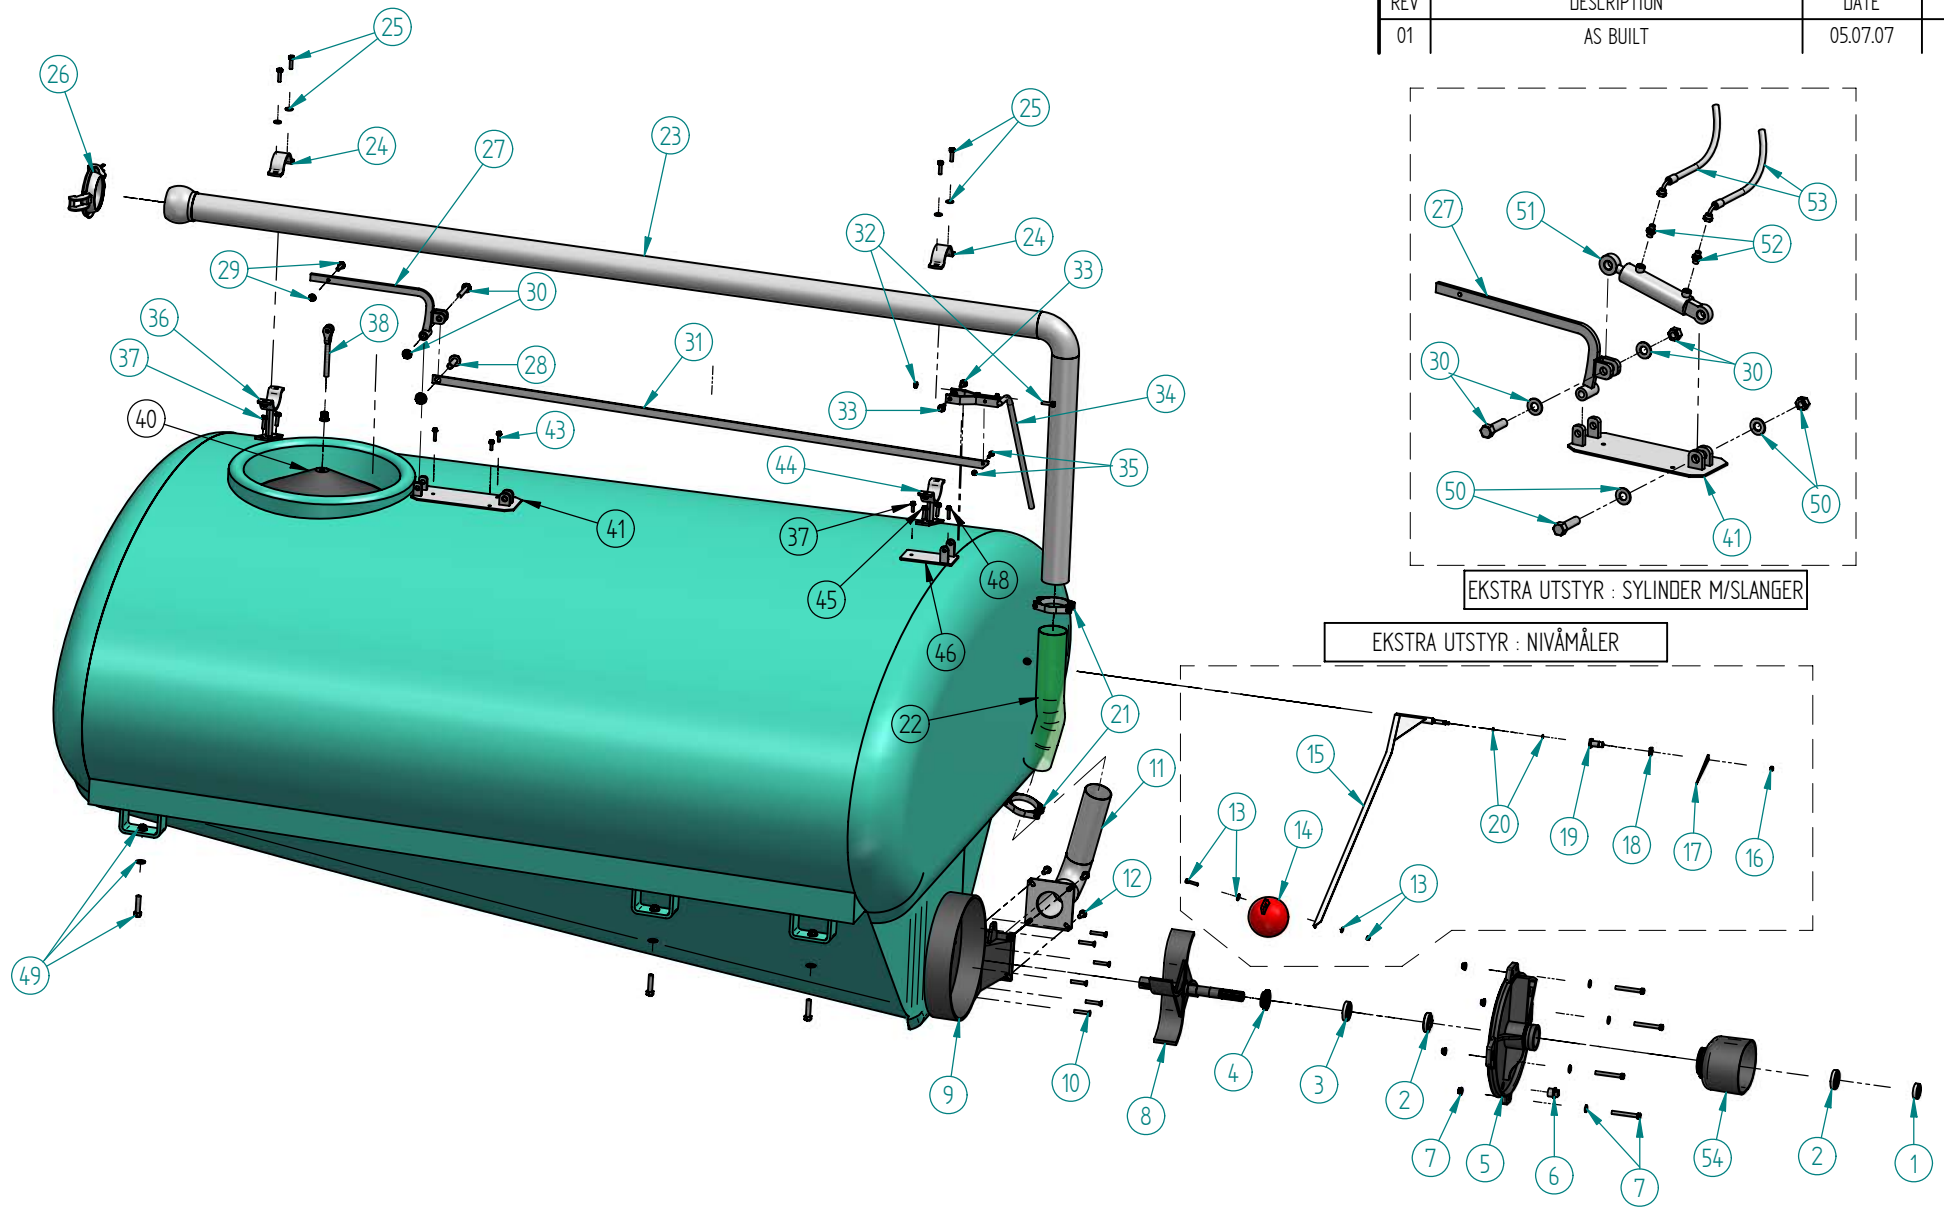

NAME		DATE	TITLE		
S. Hetland		05/07/07	EKSPLODERT SAMMENTILLING FOR DOFF XXX STANDARD		
DRAWN	SIZE	DWG NO	REF TO	REV	
	A3	C - 900		01	
FILE NAME: C - 900 - Doff X9 - Tank - Eksplovert Sammentilling		SCALE: 1 : 20	WEIGHT:	SHEET 1 OF 1	

moi A/S

DELELISTE FOR DOFF X4 - X5 - X9 - X11 - X15

POS.NR.	DELE.NR.	PRODUKTNAVN	ANT.
1	633532	STOPPRING M/UMBRACOSKRUE	1
2	533529	LAGER 6207 RS	2
3	533531	LAGER 6207	1
4	533528	VANNPUMPEPAKNING	1
5	533530	LOKK OG LAGERHUS (MOI 600)	1
6	510501	AVTAPPNINGSPLUGG 1"	1
7	533543	BOLT M/SKIVE & LÅSEMUTTER M12 X 100	4
8	533526	PROPELL FOR 3-LAGER	1
9	533501	PUMPEHUS MOI 530	1
10	510530	BOLT M/SENKET HODE & SKIVE/MUTTER M10 X 60	6
11	533564	RØR 4" M/FLENS X5-X9	1
11	533565	RØR 5" M/FLENS X11-X15	1
12	536022	BOLT M/SKIVE & LÅSEMUTTER M12 X 50	4
13	546556	RUSTFRI BOLT M/SKIVE & LÅSEMUTTER M8 X 30	1
14	546535	PLASTKULE	1
15	546534	RUSTFRI MÅLESTANG M/AKSEL	1
16	546539	RUSTFRI LÅSEMUTTER M8	1
17	546540	RUSTFRI VISERPIL	1
18	510526	BACKNUTS MESSING 1/2"	1
19	546537	MESSINGFORING M/GJENGER 1/2"	1
20	510525	O-RING	2
21	707027	SLANGEKLEMME 4"	2
22	7070256	FLEXISLANGE 4" DOFF X4,X5,X9 Lengde 600mm	1
22	7070266	FLEXISLANGE 5" DOFF X11,X15 Lengde 600mm	1
23	10291	SPREDERØR 4" DOFF X4 KL. 3100 X 300	1
23	10293	SPREDERØR 4" DOFF X5 KL. 3500 X 500	1
23	10292	SPREDERØR 4" DOFF X9 KL. 3300 X 500	1
23	10294	SPREDERØR 5" DOFF X11 KL. 3950 X 1000	1
23	10295	SPREDERØR 5" DOFF X15 KL. 4900 X 1000	1
24	10347	ØVRE LÅSEFESTE TIL SPREDERØR 5"	1
24	10344	ØVRE LÅSEFESTE TIL SPREDERØR 4"	2
25	536022	BOLT M/SKIVE & LÅSEMUTTER M12 X 40	4
26	80503	BAUERKLEMME 5"	1
26	80531	BAUERKLEMME 4"	1
27	536068	LØFTEARM	1
28	536069	BOLT M/SKIVE & LÅSEMUTTER M16 X 100	1
29	536026	BOLT M/SKIVE & LÅSEMUTTER M12 X 50	1
30	536071	BOLT M/SKIVE & LÅSEMUTTER M20 X 70	1
31	5360724	TREKKSTAG DOFF X4 KL.1920	1
31	5360725	TREKKSTAG DOFF X5 KL.2310	1
31	5360729	TREKKSTAG DOFF X9 KL. 2170	1
31	5360721	TREKKSTAG DOFF X11 KL. 2790	1
32	536022	BOLT M/LÅSEMUTTER M12 X 40	1
33	536022	BOLT M/SKIVE & LÅSEMUTTER M12 X 40	2
34	536074	MANØVRERINGSPAK	1
35	546550	BOLT M/SKIVE & LÅSEMUTTER M8 X 40	1
36	10348	BAKRE TANKFESTE TIL SPREDERØR 4"	1
36	10349	BAKRE TANKFESTE TIL SPREDERØR 5"	
37	533508	BOLT M/SKIVE & LÅSEMUTTER M10 X 40	2
38	536066	GAFFEL M/GJENGER TIL LOKK INKL.SKIVE/MUTTER	1
40	536065	LOKK	1
41	536070	BAKRE FESTEBRACKET	1
43	546550	BOLT M/SKIVE & LÅSEMUTTER M8 X 40	4
44	546527	FREMRE / BAKRE TANKFESTE 4" Kompl.	2
44	5465275	FREMRE / BAKRE TANKFESTE 5" Kompl.	2

DELELISTE FOR DOFF X4 - X5 - X9 - X11 - X15

45	533508	BOLT M/SKIVE & LÅSEMUTTER M10 X 40	2
46	536076	FREMRE FESTEBRACKETT	1
47	546550	BOLT M/SKIVE & LÅSEMUTTER M8 X 40	1
48	546550	BOLT M/SKIVE & LÅSEMUTTER M8 X 40	4
49	801063	BOLT M/SKIVE & LÅSEMUTTER M12X50 X4-X5	4
49	801077	BOLT M/SKIVE & LÅSEMUTTER M12X130	2
49	631053	BOLT M/SKIVE & LÅSEMUTTER M16 X 50 X9-X11-X15	6
50	631055	BOLT M/SKIVE & LÅSEMUTTER M20 X 70	1
51	546563	HYDRAULISK SYLINDER TIL ÅPNE/LUKKE LOKK	1
52	546572	STRUPENIPPEL	1
53	546564	HYDRAULISK SLANGE 1/4" DOFF X4 KL.4300-4500	2
53	546568	HYDRAULISK SLANGE 1/4" DOFF X5 KL.5400-5600	2
53	546569	HYDRAULISK SLANGE 1/4" DOFF X9 KL.5400-5600	2
53	546570	HYDRAULISK SLANGE 1/4" DOFF X11 KL.6000-6200	2
53	546571	HYDRAULISK SLANGE 1/4" DOFF X15 KL.7500-7650	2
54	538001	BESKYTTELSESVERN I PLAST	1